


MAP

SCHL

FIGURE 1

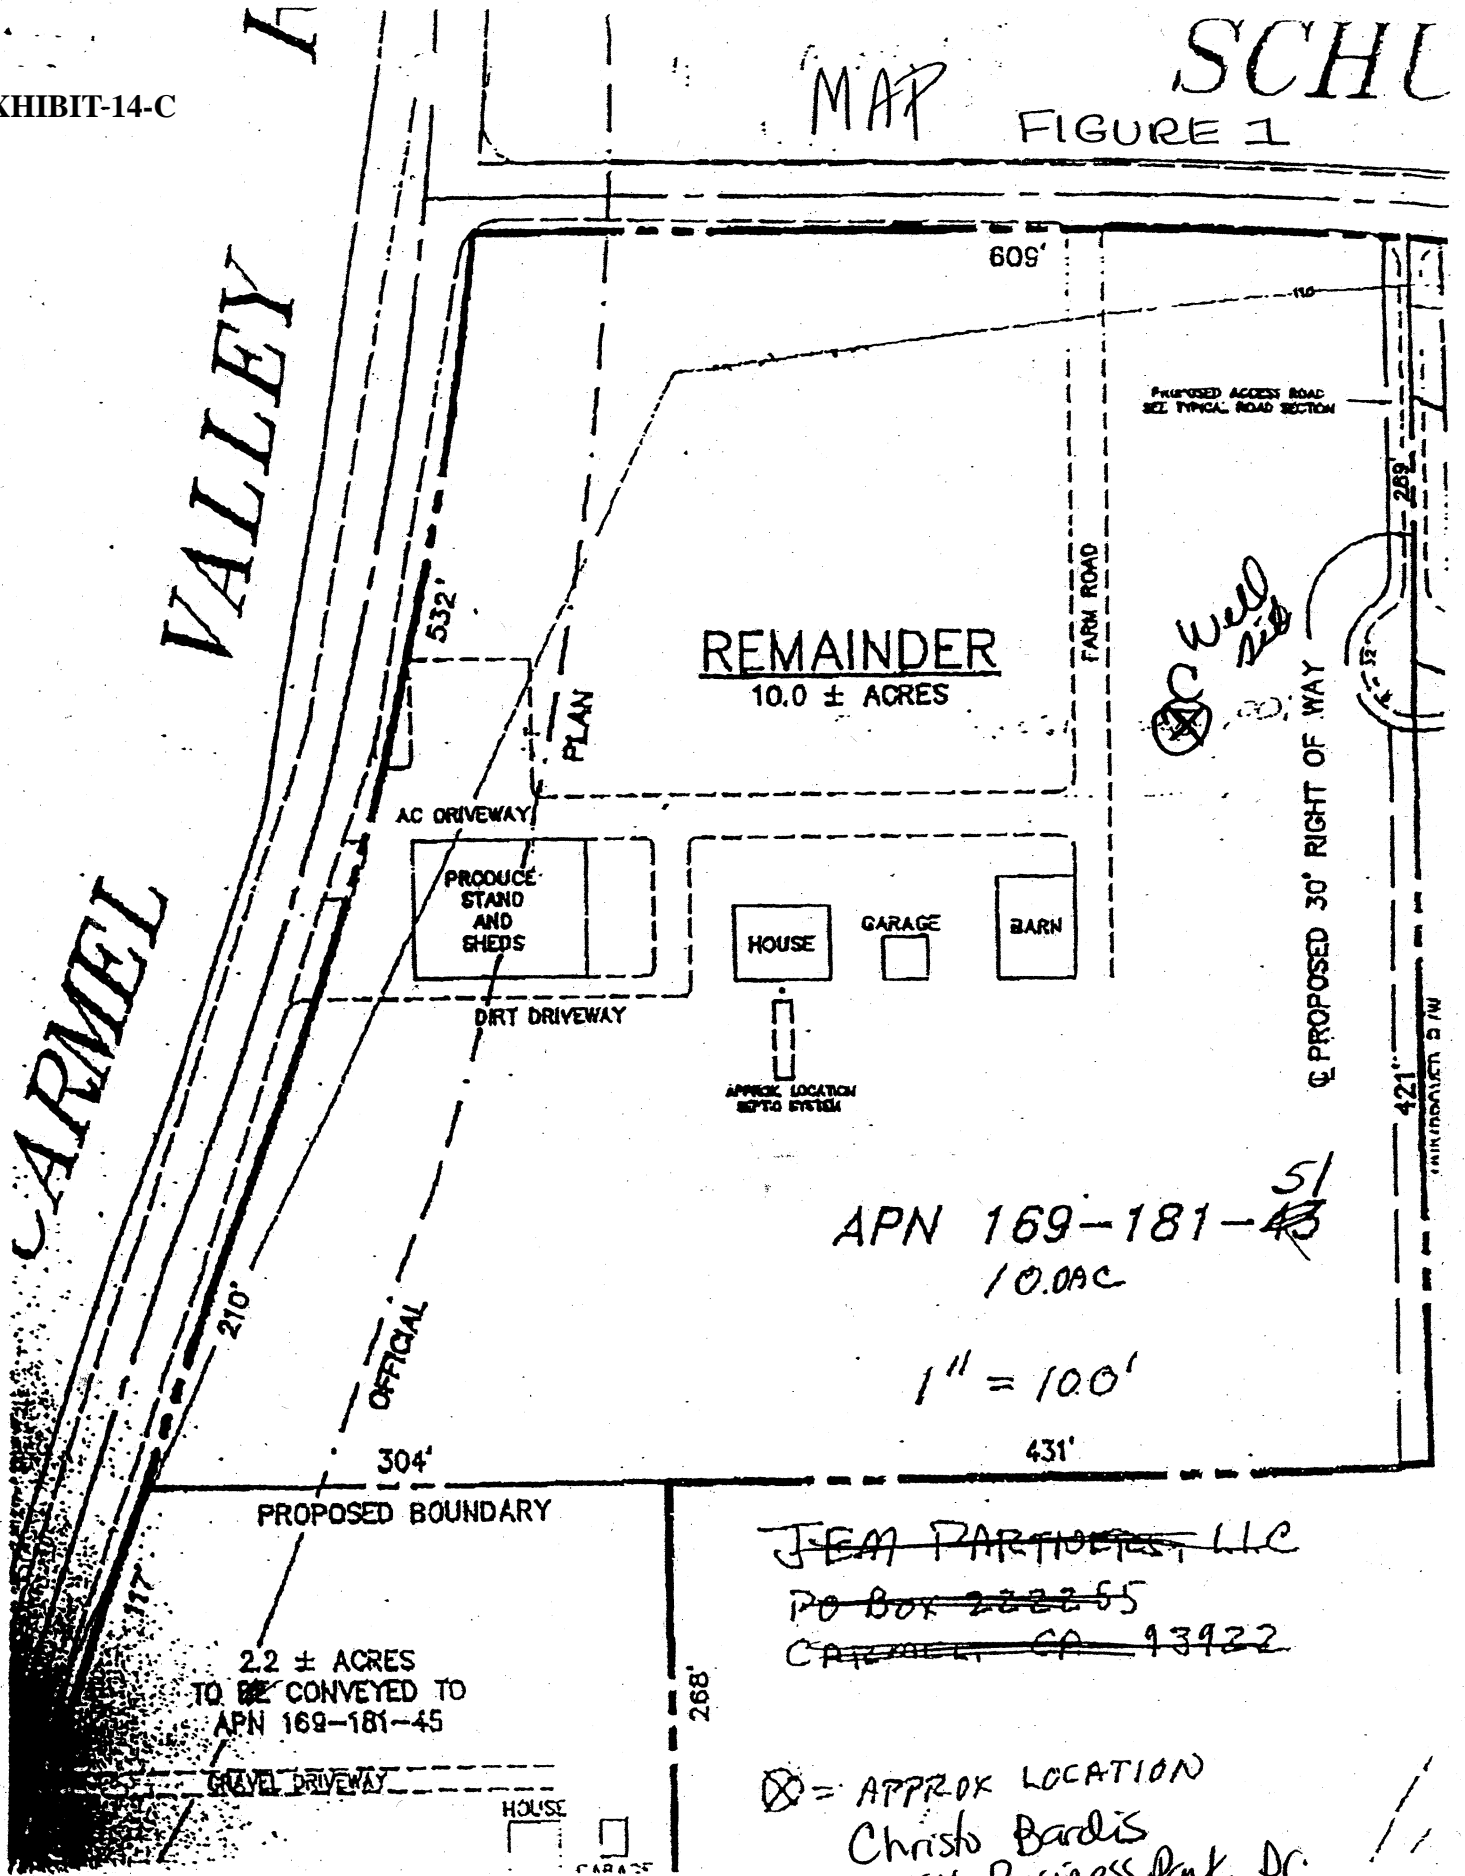

REMAINDER
10.0 ± ACRES

PRODUCE STAND AND SHEDS

HOUSE

GARAGE

BARN

APPROX LOCATION SEPTO SYSTEM

APN 169-181-~~43~~⁵¹
10.0AC

1" = 100'

2.2 ± ACRES
TO BE CONVEYED TO
APN 169-181-45

~~JEAN PARTIQUETS, LLC~~
~~PO Box 222255~~
~~CARMEL, CA 93922~~

⊗ = APPROX LOCATION
Christo Bardis
984 Business Park Dr.
Ste H
Sacramento, CA 95827